


SHEET 11 OF 15		SPEC. 11-98-5742		SCALE AS NOTED		DATE	
CONST. CONTR. NO. N87811-98-C-5742		8129762		D 80091		DATE	
REPAIR CATHODIC PROTECTION SYSTEMS		REPAIR CATHODIC PROTECTION SYSTEMS		REPAIR CATHODIC PROTECTION SYSTEMS		REPAIR CATHODIC PROTECTION SYSTEMS	
DFSP ROOSEVELT ROADS		DFSP ROOSEVELT ROADS		DFSP ROOSEVELT ROADS		DFSP ROOSEVELT ROADS	
PUERTO RICO		PUERTO RICO		PUERTO RICO		PUERTO RICO	
SOUTHWEST DIVISION		SOUTHWEST DIVISION		SOUTHWEST DIVISION		SOUTHWEST DIVISION	
8840 Complex Dr. Ste. 100		8840 Complex Dr. Ste. 100		8840 Complex Dr. Ste. 100		8840 Complex Dr. Ste. 100	
San Diego, CA 92123		San Diego, CA 92123		San Diego, CA 92123		San Diego, CA 92123	
PSG Corrosion Engineering		PSG Corrosion Engineering		PSG Corrosion Engineering		PSG Corrosion Engineering	
DEPARTMENT OF THE NAVY		DEPARTMENT OF THE NAVY		DEPARTMENT OF THE NAVY		DEPARTMENT OF THE NAVY	
NAVAL FACILITIES ENGINEERING COMMAND		NAVAL FACILITIES ENGINEERING COMMAND		NAVAL FACILITIES ENGINEERING COMMAND		NAVAL FACILITIES ENGINEERING COMMAND	




AS-BUILT DRAWINGS  
 Revised by  
 F. Lopez Jr  
 3-15-00


RECIFIER INSTALLATION (R-2, R-4)  
 CP-3, CP-5, CP-10  
 NOT TO SCALE

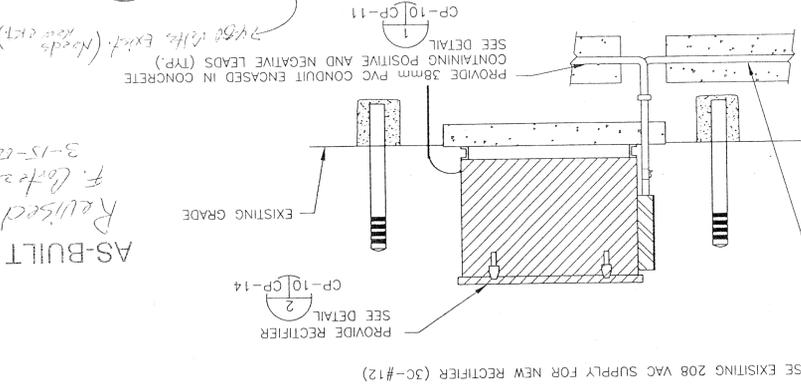

RECIFIER INSTALLATION (R-3, R-5, R-6)  
 CP-4, CP-7, CP-8, CP-10  
 NOT TO SCALE

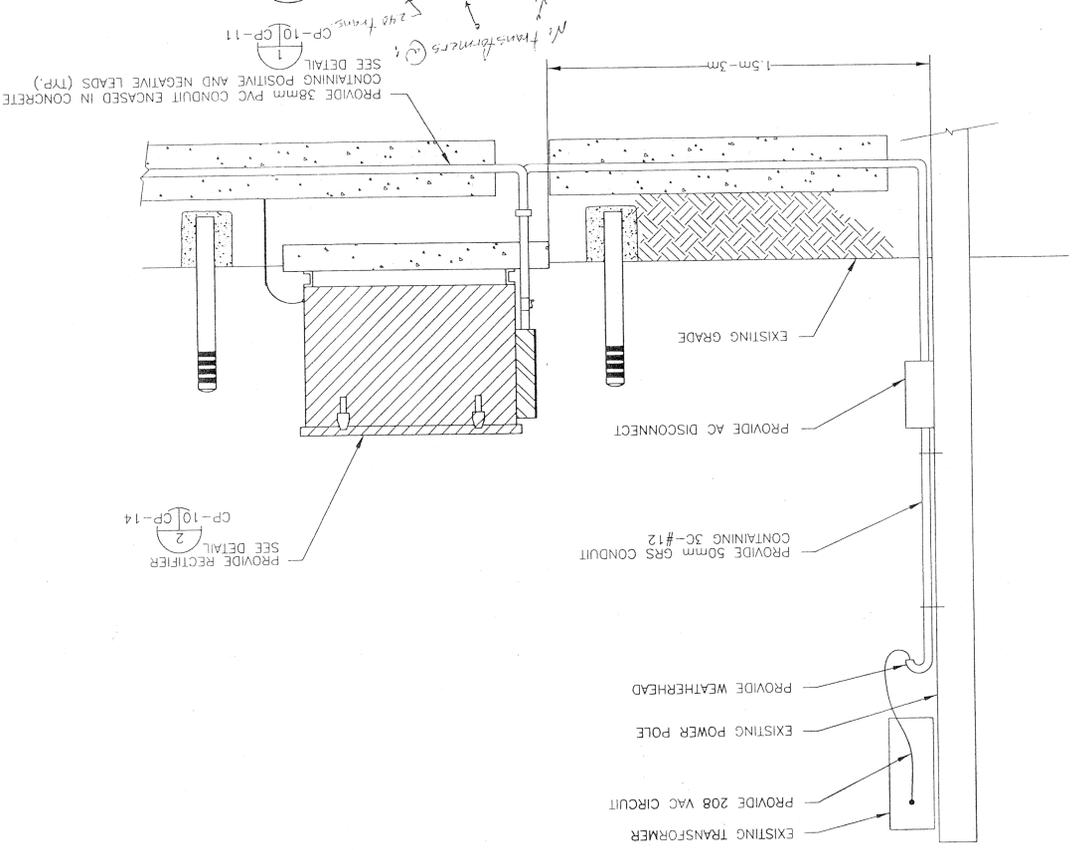

RECIFIER INSTALLATION (R-7)  
 CP-9, CP-10  
 NOT TO SCALE

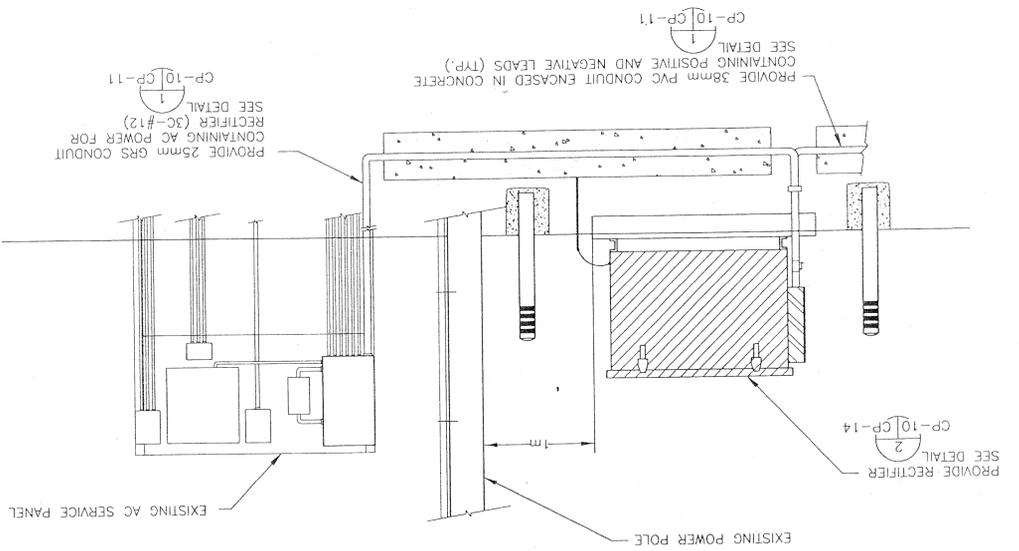

RECIFIER INSTALLATION (R-1)  
 CP-2, CP-10  
 NOT TO SCALE

