


#### ANODE WIRE INSULATION NOTES:

- "HMWPE" IS AN INDUSTRY ABBREVIATION FOR HIGH MOLECULAR WEIGHT POLYETHYLENE.

#### MIXED METAL OXIDE TUBULAR ANODE

NOT TO SCALE


CP-11, CP-12

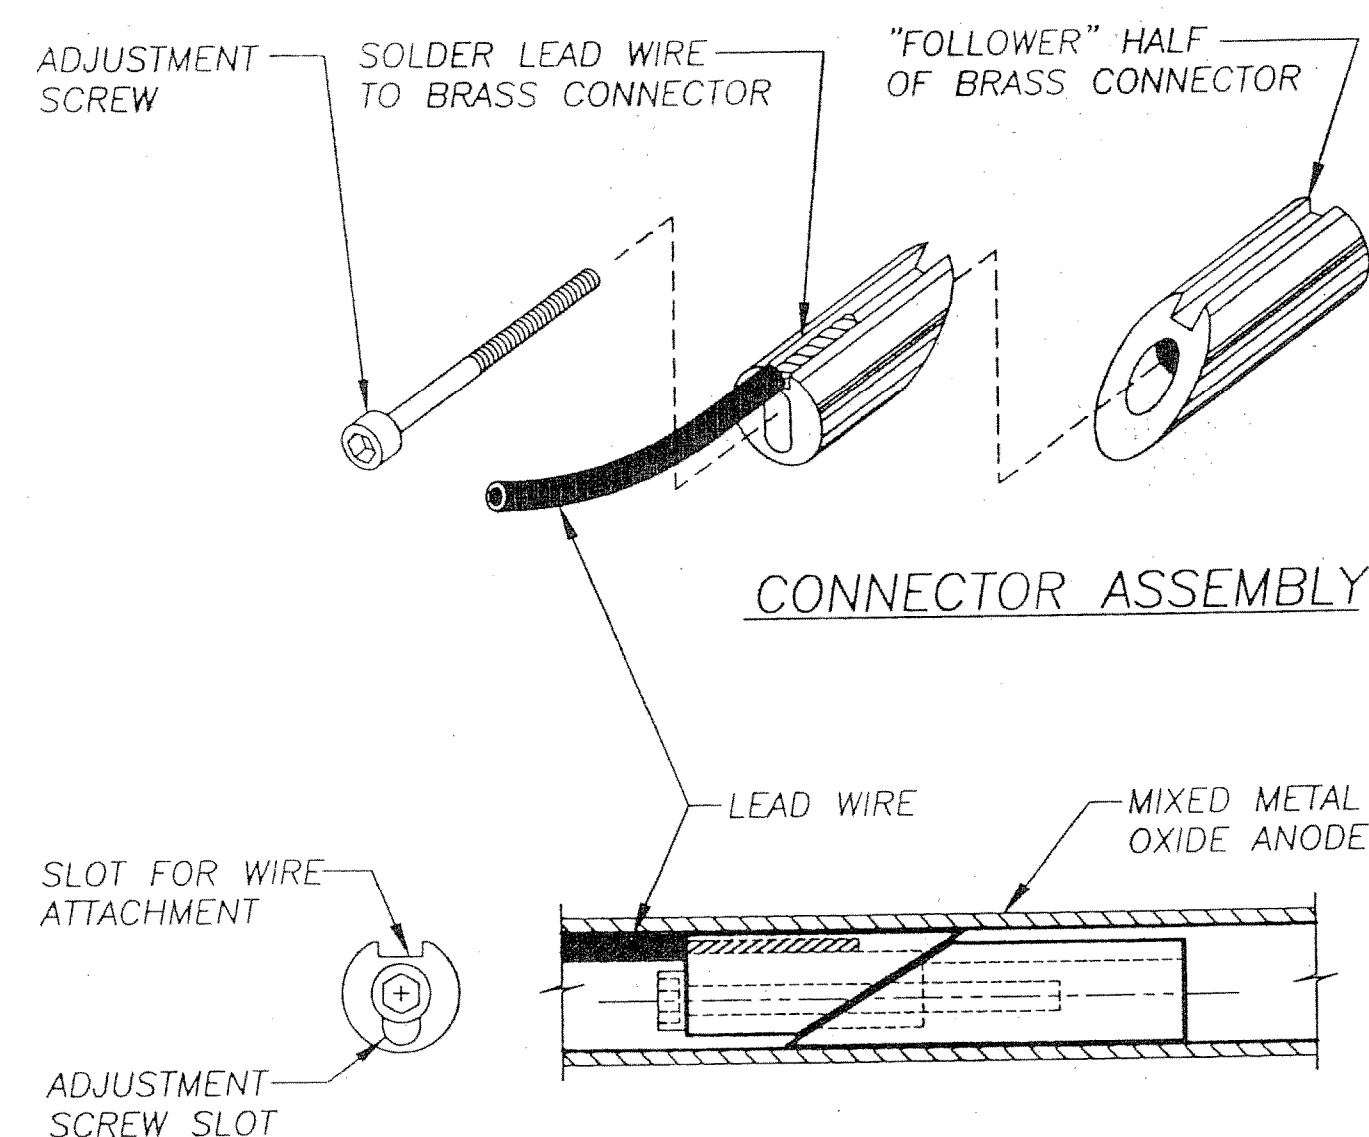

#### LEAD WIRE CONNECTION DETAIL

NOT TO SCALE


CP-12

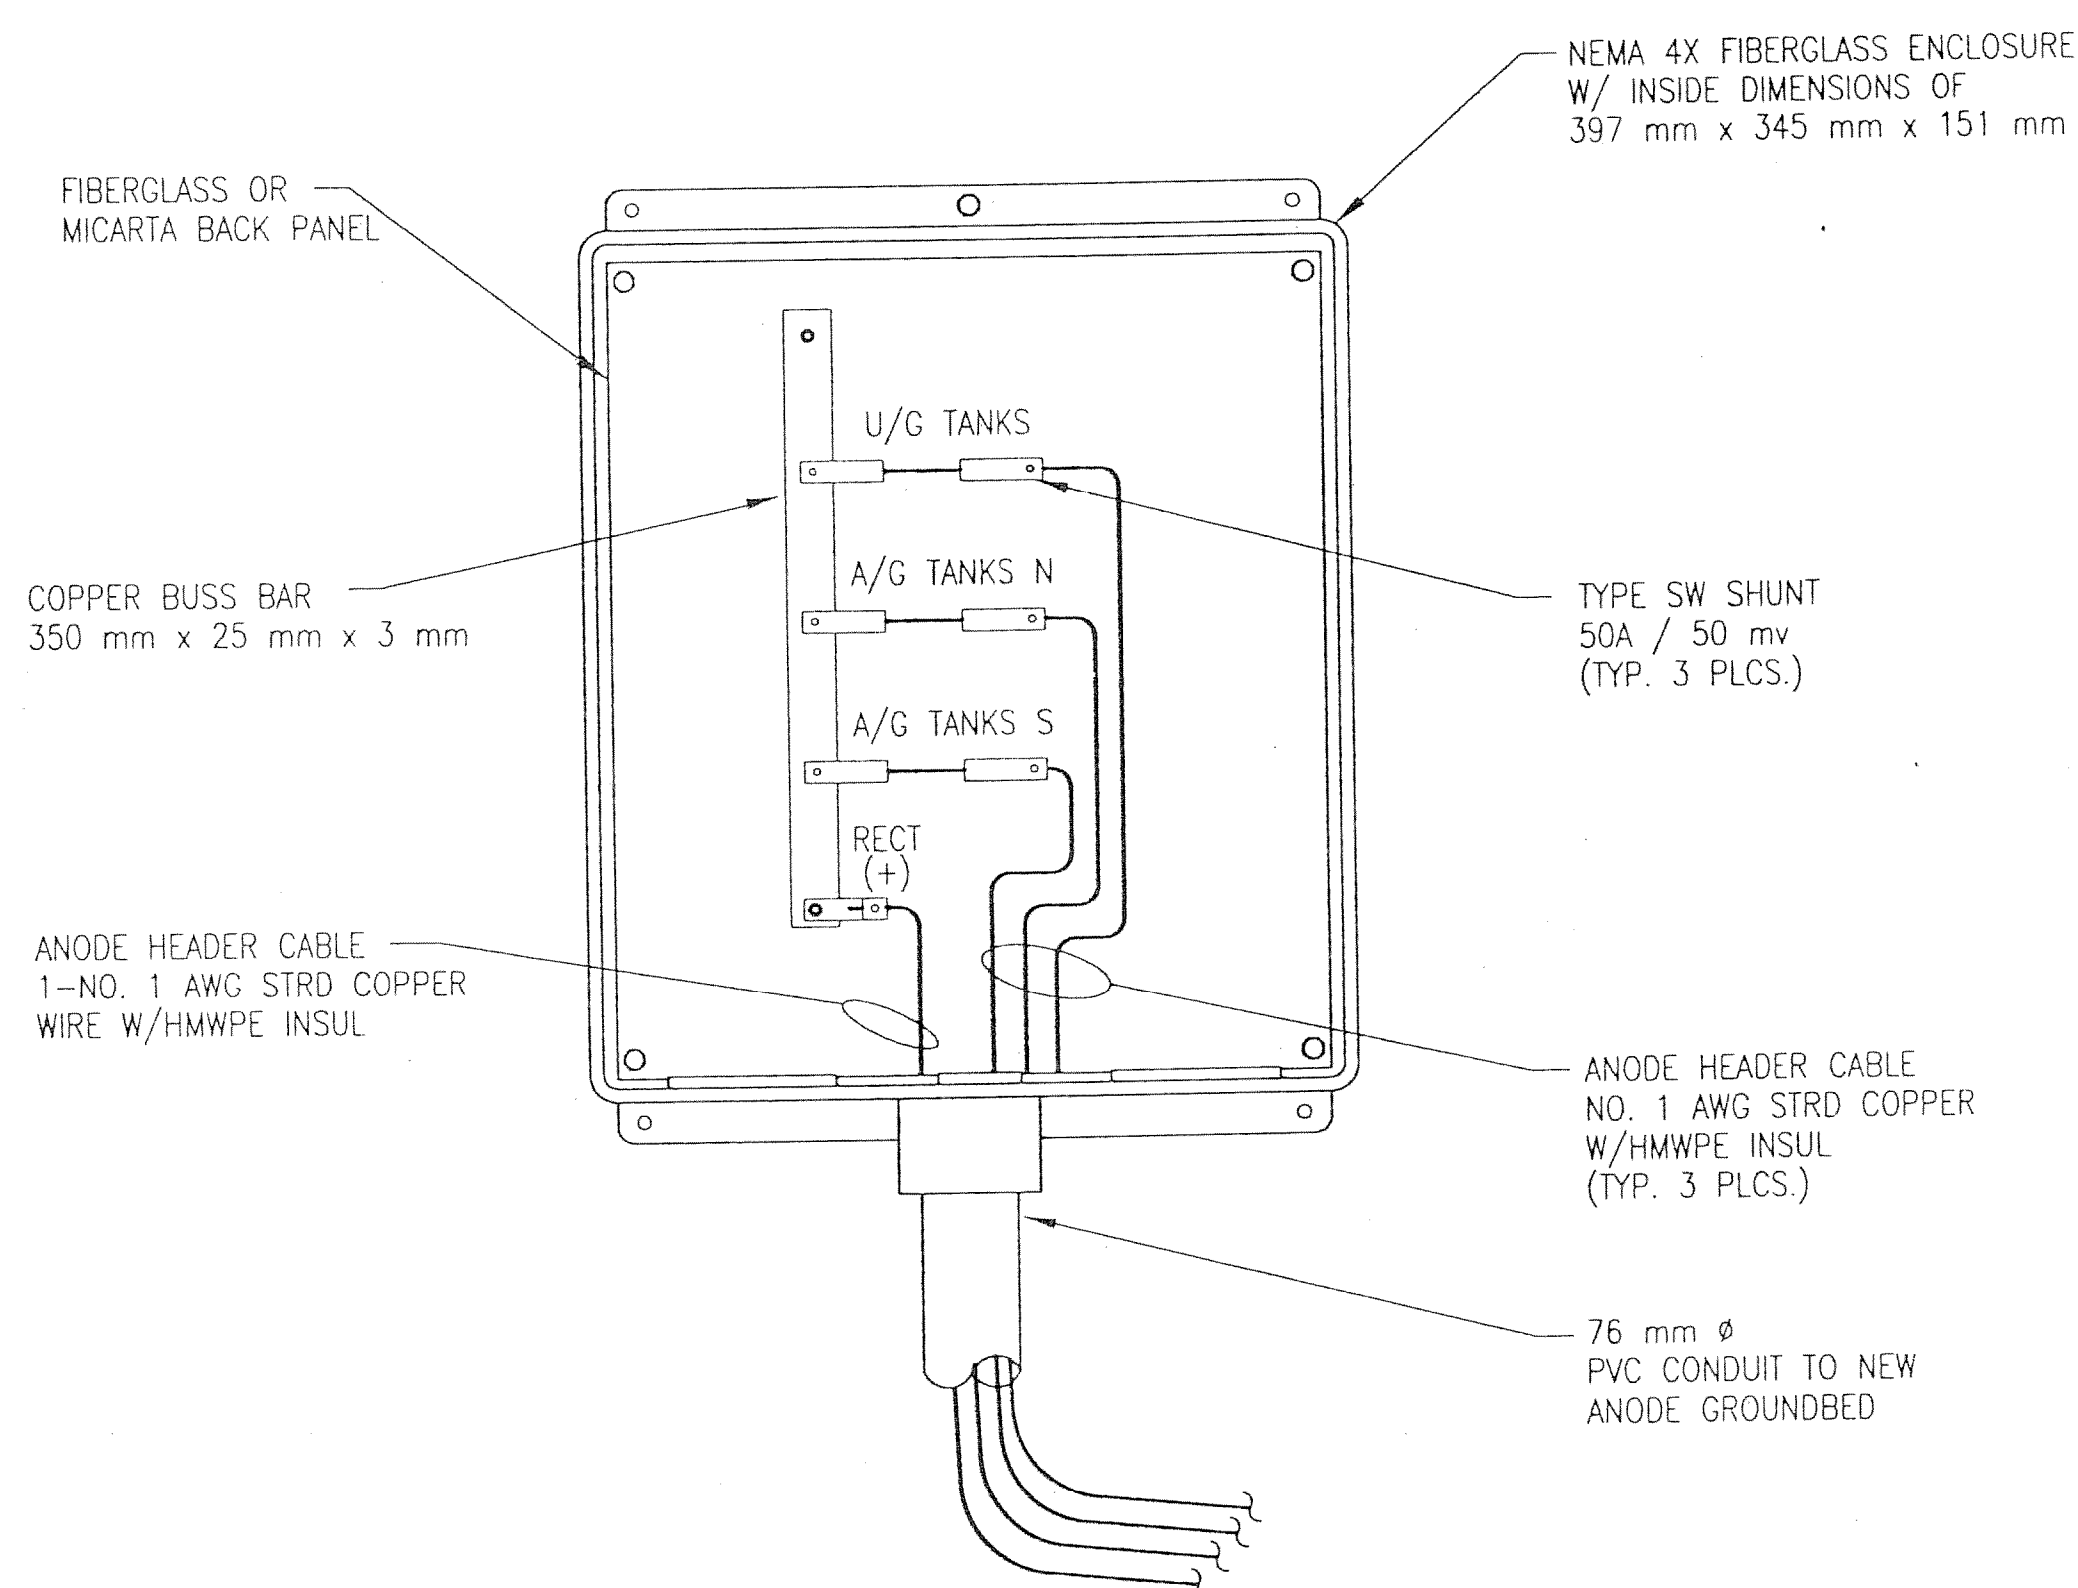

#### HEADER CABLE JUNCTION BOX

NOT TO SCALE


CP-12

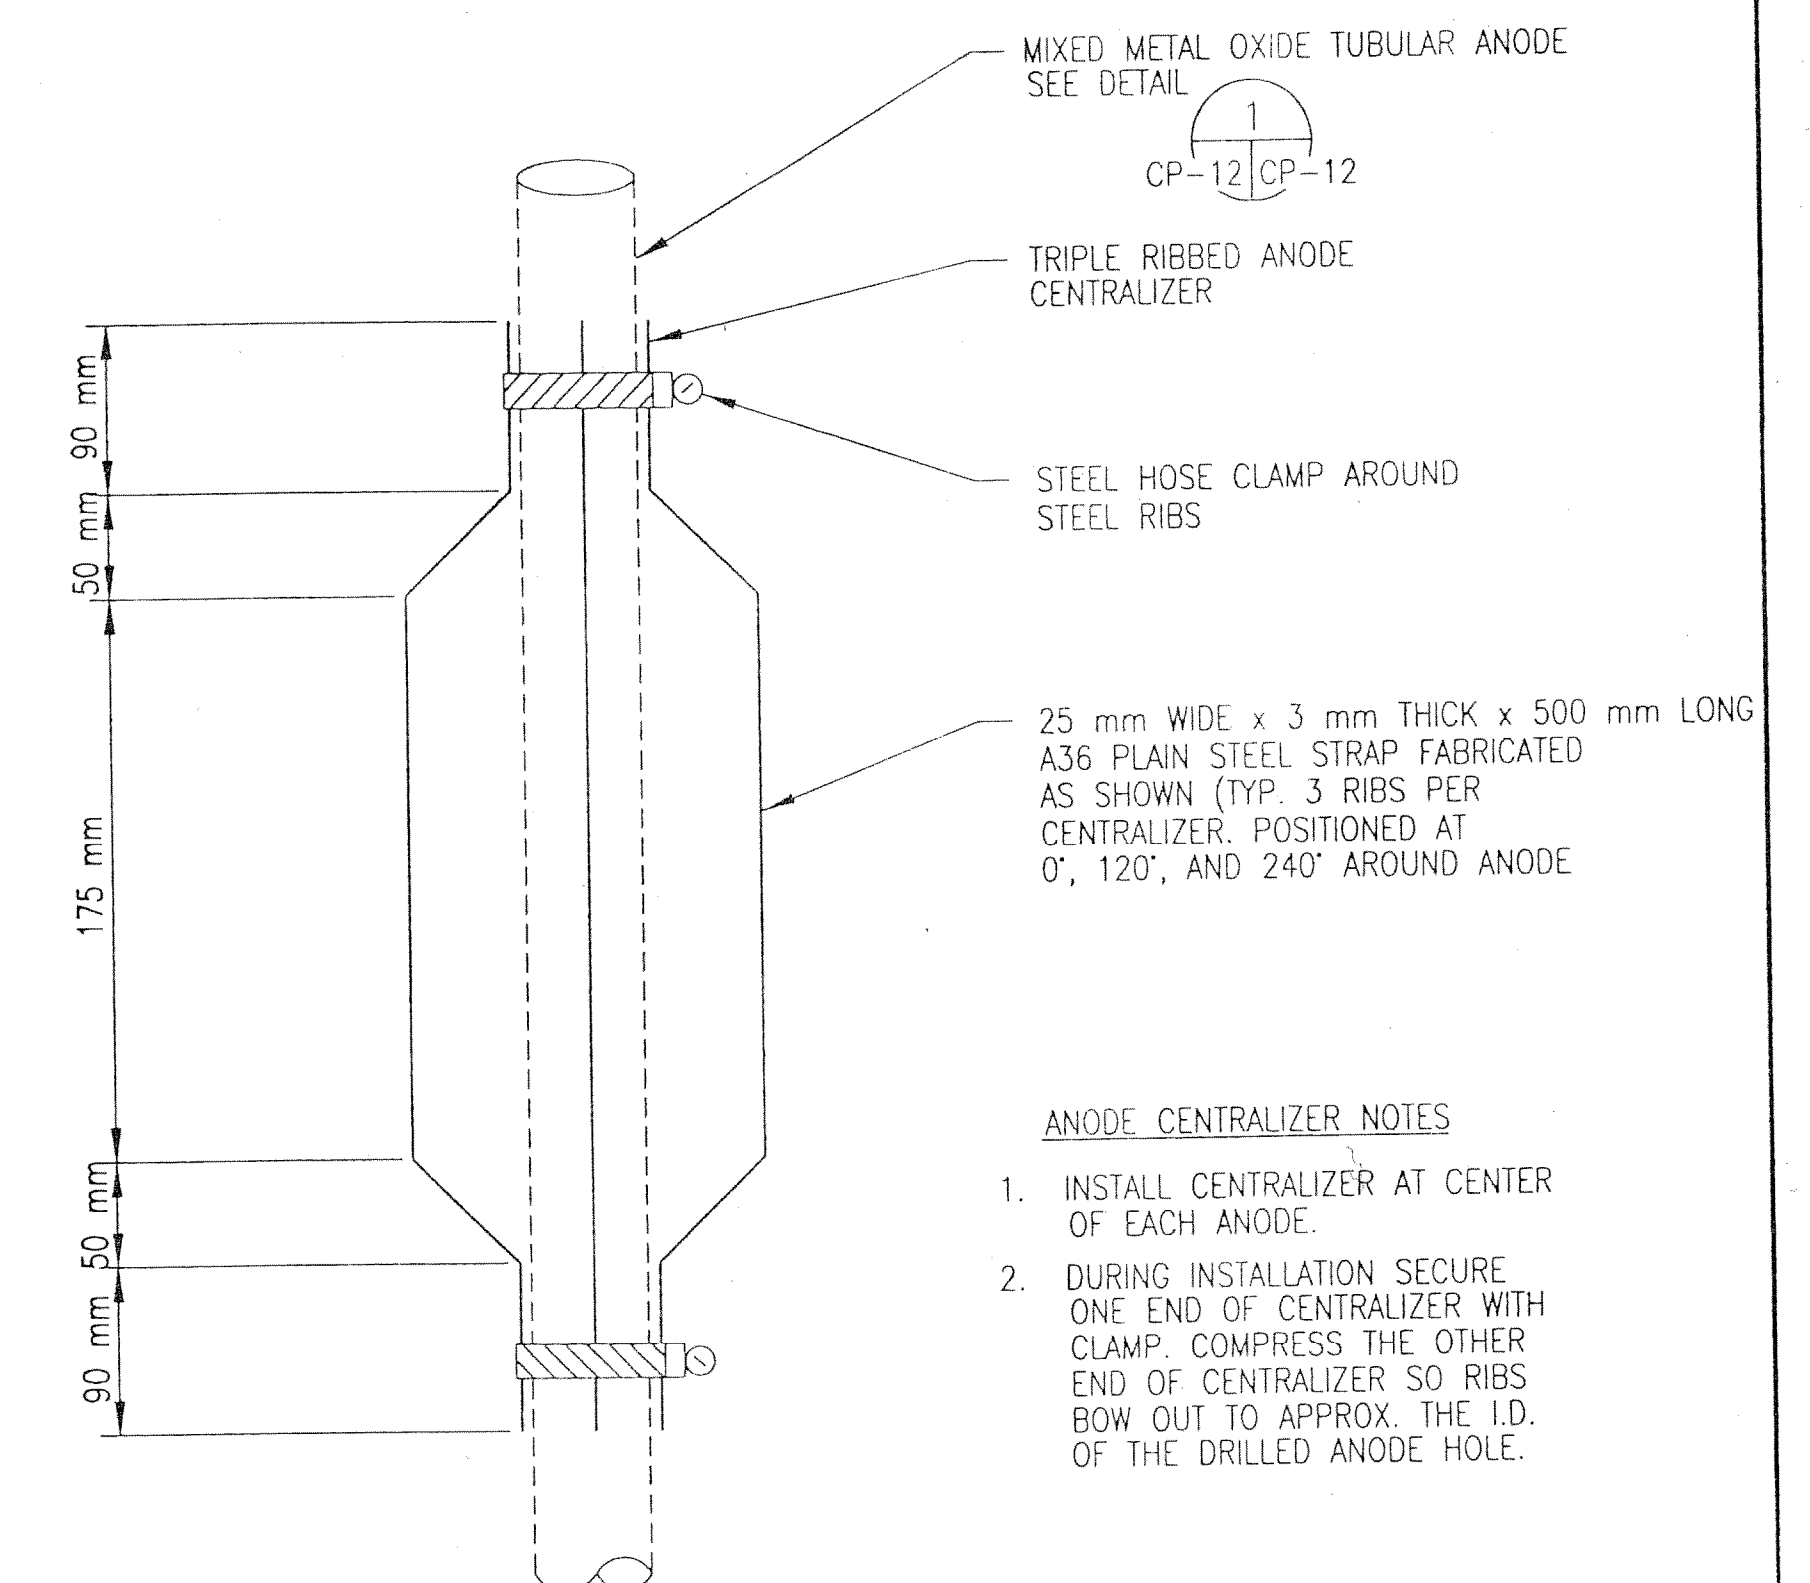

#### ANODE CENTRALIZER ASSEMBLY

NOT TO SCALE

CP-11

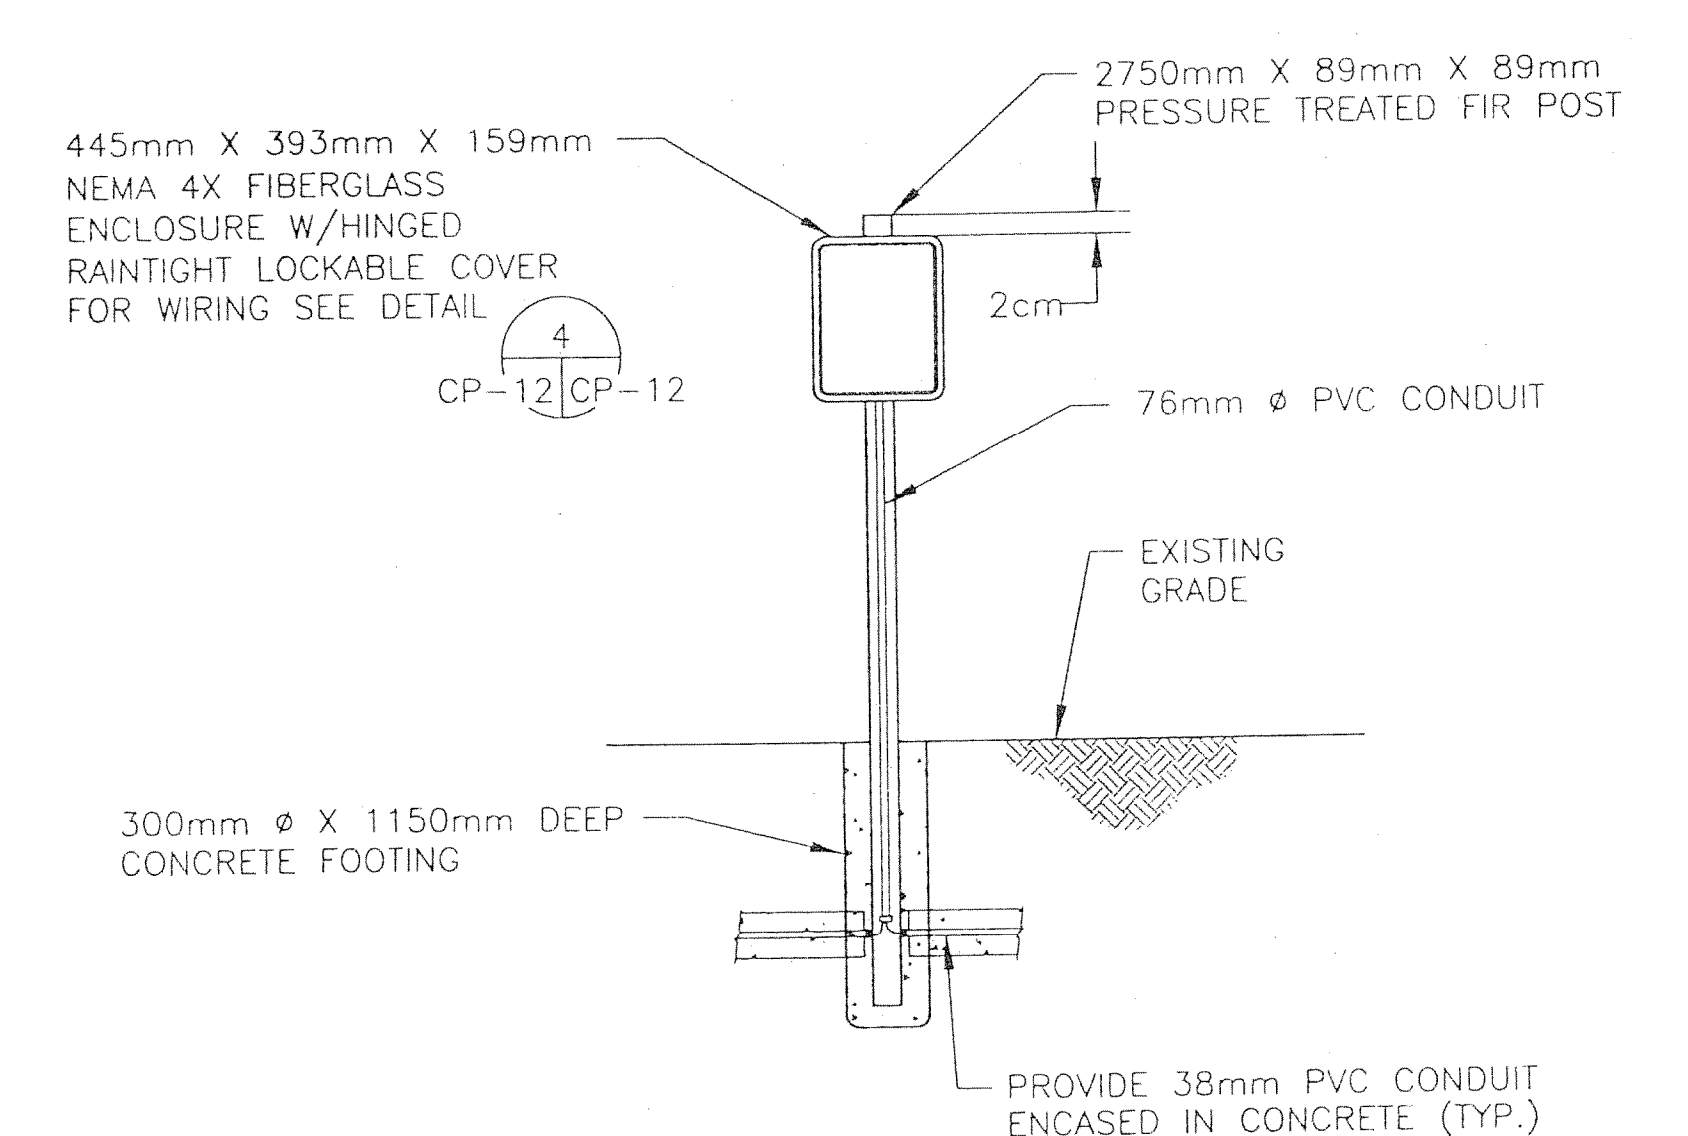

#### HEADER CABLE JUNCTION BOX INSTALLATION

NOT TO SCALE

CP-4



AS-BUILT DRAWINGS  
Revised by F. Carter 3-15-00

PSC Corrosion Engineering 8840 Complex Dr. Ste. 100 San Diego, CA 92123				DEPARTMENT OF THE NAVY NAVAL FACILITIES ENGINEERING COMMAND SOUTHWEST DIVISION SAN DIEGO, CALIFORNIA			
DES. CHK	DR. EC	CHK. PUR		DFSP ROOSEVELT ROADS			
SUPV. CHM	CH. ENG. RBJ	DATE		DESC PROJECT FY 97, RRD 97-3			
SUBMITTED BY	DATE			REPAIR CATHODIC PROTECTION SYSTEMS			
FIRM MEMBER (TITLE)	DISTRICT MGR.			DFSP ROOSEVELT ROADS			
SW DIV. NPEC: RVD	BR. MGR.			ANODE, ANODE CENTRALIZER,			
DFPE	PDE	INBM		AND JUNCTION BOX DETAILS			
DIV							
APPROVED							
FOR COMMANDER NAVFAC	DATE						
SCALE	AS NOTED						
SPEC. 11-98-5742							
SHEET 13 OF 15							

CP-12

SATISFACTORY TO

DATE

TITLE