



CABLE TRENCH DETAIL  
NOT TO SCALE CP-1, CP-2, CP-3, CP-4, CP-5, CP-7, CP-8, CP-9, CP-10, CP-11

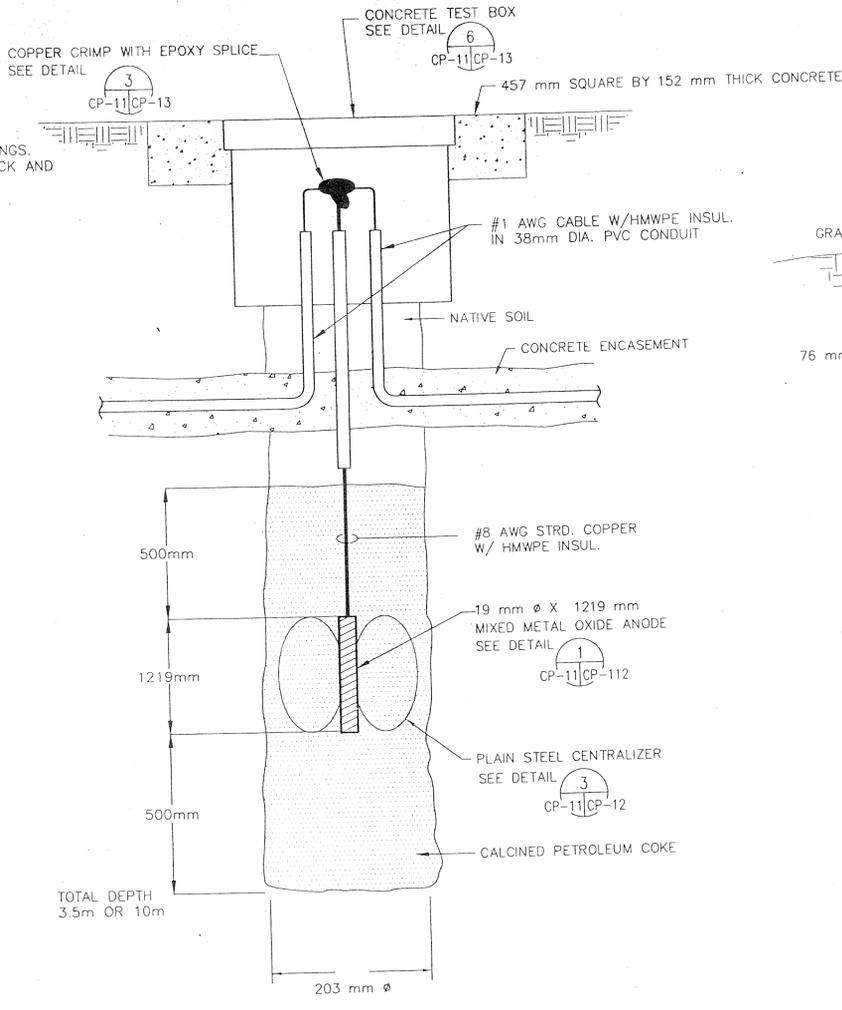


CP SYSTEM	DEPTH OF ANODE HOLE
R-1	3.5m
R-2	3.5m
R-3	10.0m
R-4	10.0m
R-5	3.5m
R-6	3.5m
R-7	10.0m


SHALLOW ANODE DETAIL  
NOT TO SCALE CP-1, CP-2, CP-3, CP-4, CP-5, CP-7, CP-8, CP-9, CP-11

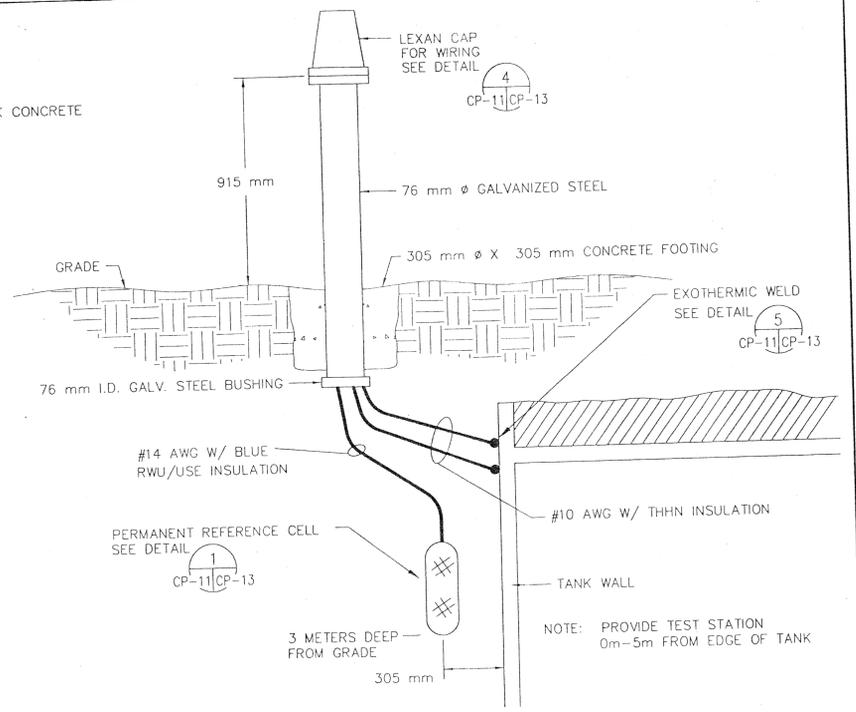

BELOW GROUND TANK TEST STATION  
NOT TO SCALE CP-4, CP-5, CP-9, CP-11

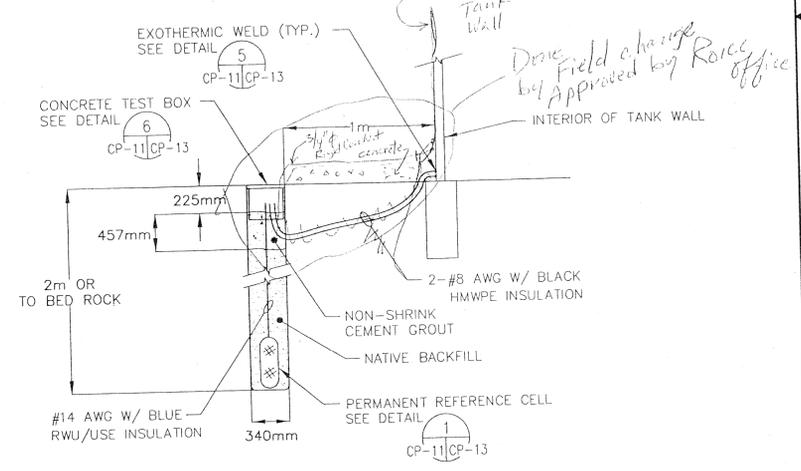

ABOVE GROUND TANK TEST STATION  
NOT TO SCALE CP-4, CP-5, CP-9, CP-11

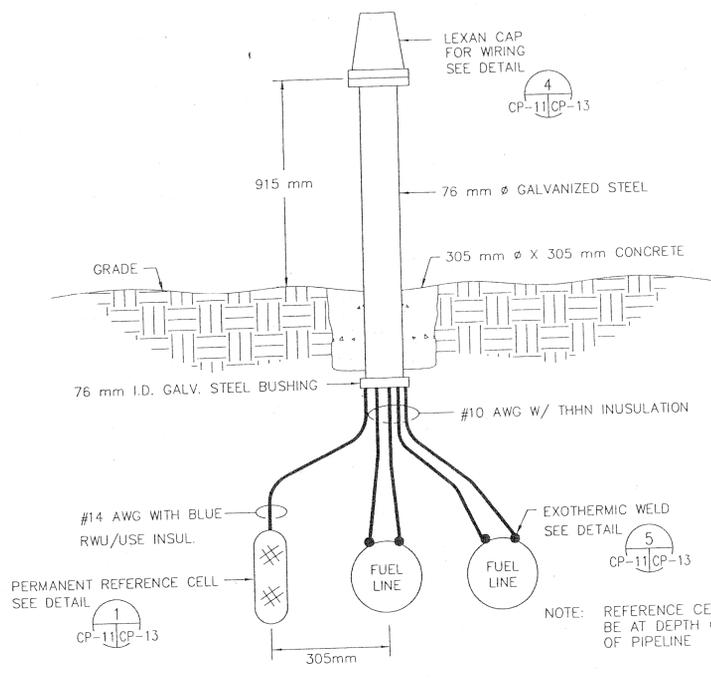

PIPELINE TEST STATION  
NOT TO SCALE CP-2, CP-3, CP-6, CP-11

AS-BUILT DRAWINGS  
Revised by  
F. Carter  
3-15-00

CP-11	SATISFACTORY TO	DATE
	TITLE	

PSG Corrosion Engineering 8840 Complex Dr. Ste. 100 San Diego, CA 92123	DEPARTMENT OF THE NAVY NAVAL FACILITIES ENGINEERING COMMAND SOUTHWEST DIVISION SAN DIEGO, CALIFORNIA
DES CKM SUPV CKM SUBMITTED BY FIRM MEMBER (TITLE) SW DIV NPEC/RVD DFPE DIR	DR EC CHK P/R DATE DISTRICT MGR. BR MGR. INBM
APPROVED	FOR COMMANDER NAVFAC
SIZE D	CODE IDENT. NO. 80091
CONST. CONTR. NO. N67811-98-C-5742	NAVFAC DRAWING NO. 8129763
SPEC. 11-98-5742	SHEET 12 OF 15

