


DESC PROJECT FY 97, RRD 97-3

REPAIR CATHODIC PROTECTION SYSTEMS

DFSP ROOSEVELT ROADS, PUERTO RICO

CONST. CONTRACT NO. N68711-98-C-5472

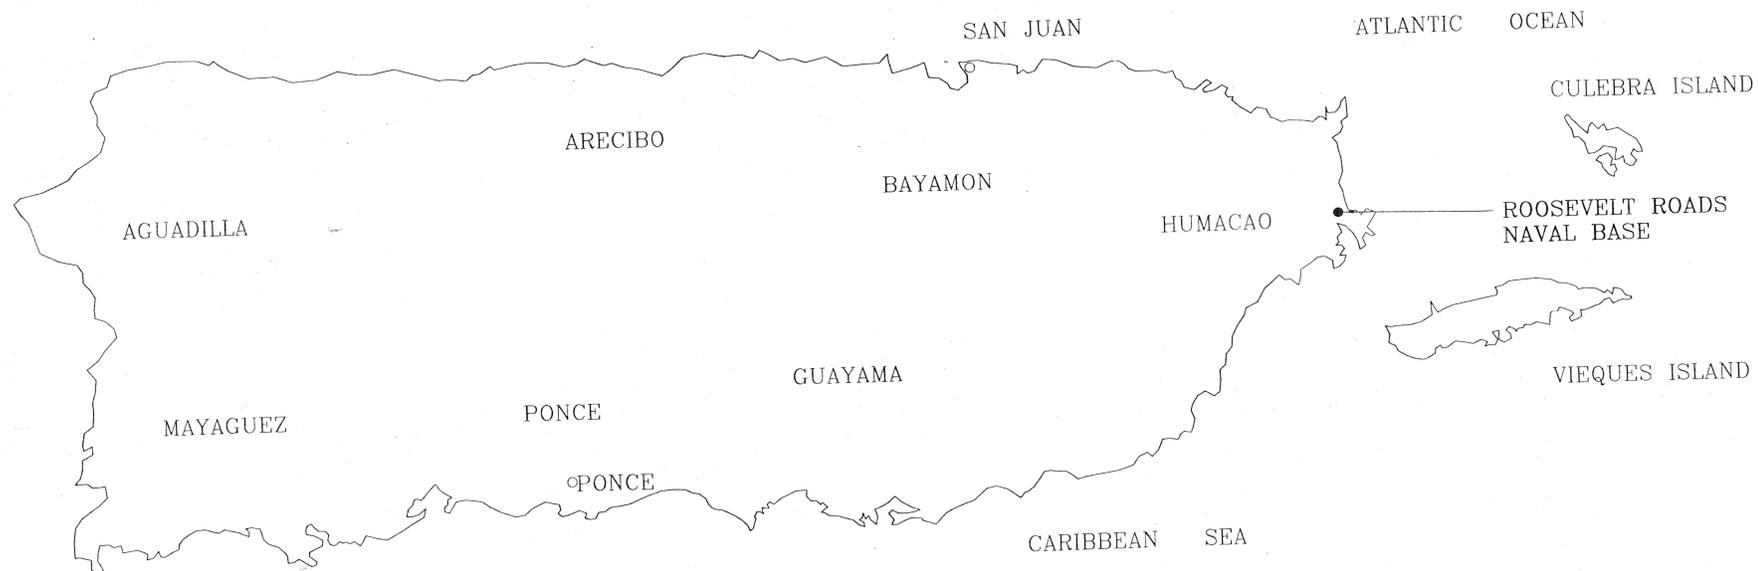

PROJECT LIST OF DRAWINGS

SHT. NO.	REF. NO.	NAVFAC DWG NO.	TITLE
1	T-1	8129752	TITLE SHEET, LOCATION MAP AND LIST OF DRAWINGS
2	CP-1	8129753	OVERALL SITE PLAN
3	CP-2	8129754	RECTIFIER R-1 CATHODIC PROTECTION SYSTEM
4	CP-3	8129755	RECTIFIER R-2 CATHODIC PROTECTION SYSTEM
5	CP-4	8129756	RECTIFIER R-3 CATHODIC PROTECTION SYSTEM
6	CP-5	8129757	RECTIFIER R-4 CATHODIC PROTECTION SYSTEM
7	CP-6	8129758	RECTIFIER R-5 SITE PLAN
8	CP-7	8129759	RECTIFIER R-5 CATHODIC PROTECTION SYSTEM
9	CP-8	8129760	RECTIFIER R-6 CATHODIC PROTECTION SYSTEM
10	CP-9	8129761	RECTIFIER R-7 CATHODIC PROTECTION SYSTEM
11	CP-10	8129762	RECTIFIER INSTALLATIONS
12	CP-11	8129763	TRENCH DETAIL, ANODE INSTALLATION, TANK AND PIPELINE TEST STATIONS
13	CP-12	8140392	ANODE, ANODE CENTRALIZER, AND JUNCTION BOX DETAILS
14	CP-13	8140393	MISCELLANEOUS DETAILS
15	CP-14	8140414	MISCELLANEOUS DETAILS

ABBREVIATIONS


GALV.	GALVANIZED
I.D.	INSIDE DIAMETER
INSUL.	INSULATION
mm	MILLIMETER
m	METER
HMWPE	HIGH MOLECULAR WEIGHT POLYETHYLENE

AS-BUILT DRAWINGS

*Revised by:
Frank Corder
Conf Rep - Receiv Office*

NOTE:

THE CONTRACTOR IS RESPONSIBLE FOR LOCATING UNDERGROUND PIPING AND UTILITIES BEFORE INSTALLING ANODES, CABLES, OR TEST STATIONS.

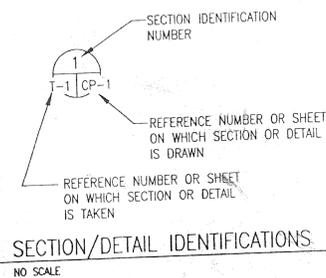

IF SHEET IS LESS THAN 594 X 841 IT IS A REDUCED PRINT SCALE REDUCED ACCORDINGLY

THE CONTRACTOR SHALL BE RESPONSIBLE FOR COORDINATING THE WORK AMONG THE VARIOUS TRADES AS NECESSARY TO AVOID CONFLICTS AND TO INSURE THE INSTALLATION OF ALL WORK WITHIN THE AVAILABLE SPACE.

T-1 SATISFACTORY TO DATE 4/30/97

PSG Corrosion Engineering 8840 Complex Dr. Ste. 100 San Diego, CA 92123		DEPARTMENT OF THE NAVY NAVAL FACILITIES ENGINEERING COMMAND SOUTHWEST DIVISION SAN DIEGO, CALIFORNIA	
DES CKM SUPV CKM SUBMITTED BY: <i>[Signature]</i> DATE: 4/30/97 FIRM MEMBER (TITLE) DISTRICT MGR: SW DIV NPEC: RVO BR MOP: <i>[Signature]</i> DIR: POE: <i>ATT</i> INSM:		DFSP ROOSEVELT ROADS DESC PROJECT FY 97, RRD 97-3 REPAIR CATHODIC PROTECTION SYSTEMS DFSP ROOSEVELT ROADS TITLE SHEET, LOCATION MAP AND LIST OF DRAWINGS	
APPROVED: <i>[Signature]</i> 4/30/97 FOR COMMANDER NAVFAC		SIZE: D CODE IDENT. NO.: 80091 NAVFAC DRAWING NO.: 8129752 CONST. CONTR. NO.: N68711-98-C-5472 SPEC. 11-98-5742 SHEET 1 OF 15	

