





CATHODIC PROTECTION LEGEND

- NEW CATHODIC PROTECTION RECTIFIER
- EXISTING UNDERGROUND STEEL C & C FUEL TANK
- EXISTING UNDERGROUND CONCRETE C & C FUEL TANK
- NEW CATHODIC PROTECTION CABLE MARKER
SEE DETAIL CP-1/CP-13
- EXISTING POWER POLE

DFSP ROOSEVELT ROADS - OVERALL SITE PLAN
SCALE 1:3600

AS-BUILT DRAWINGS

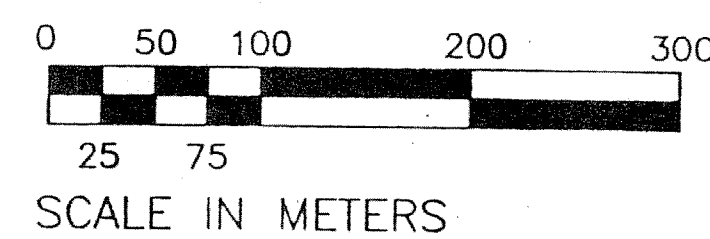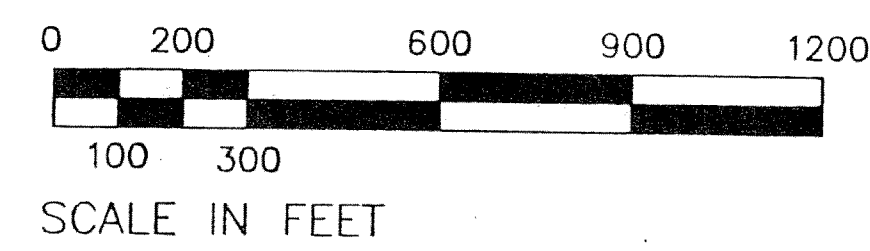

IF SHEET IS LESS THAN
594 X 841
IT IS A REDUCED PRINT
SCALE REDUCED ACCORDINGLY

THE CONTRACTOR SHALL BE RESPONSIBLE
FOR COORDINATING THE WORK AMONG
THE VARIOUS TRADES AS NECESSARY TO
AVOID CONFLICTS AND TO INSURE THE
INSTALLATION OF ALL WORK WITHIN THE
AVAILABLE SPACE.

CP-1	SATISFACTORY TO	DATE
	TITLE	

PSG Corrosion Engineering 8840 Complex Dr. Ste. 100 San Diego, CA 92123		DEPARTMENT OF THE NAVY NAVAL FACILITIES ENGINEERING COMMAND SOUTHWEST DIVISION SAN DIEGO, CALIFORNIA	
DESIGN: CKM SUBMITTED BY: <i>[Signature]</i> DATE: 6-30-99 FOR MEMBER (TITLE): DISTRICT MGR.		DFSP ROOSEVELT ROADS DESC PROJECT FY 97, RRD 97-3 REPAIR CATHODIC PROTECTION SYSTEMS DFSP ROOSEVELT ROADS	
SW DIV NEEC/RVD DPE: PDE DIR:		OVERALL SITE PLAN	
APPROVED		SIZE: D	
FOR COMMANDER NAVFAC		CODE IDENT. NO.: 80091	
DATE		NAVFAC DRAWING NO.: 8129753	
		CONST. CONTR. NO. N67811-98-C-5742	
		SPEC. 11-98-5742	
		SHEET 2 OF 15	

