


NOTES:


1. TANKS NO. 214 AND 215 ARE CONCRETE CUT AND COVER. THESE TANKS ARE OUT OF SERVICE. THE 12" AVGAS LINE IS ABANDONED IN PLACE.
2. INSTALL NEW MONITORING TEST STATIONS ON PIPING AS SHOWN.

RECTIFIER R-5 SITE PLAN

SCALE: 1:1200

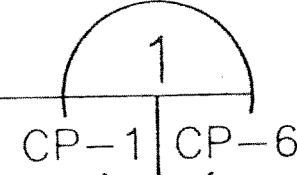

SCALE IN FEET

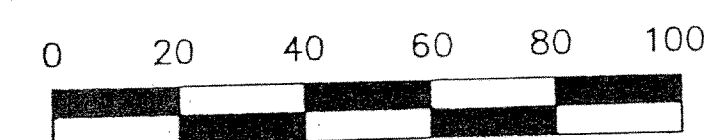

SCALE IN METERS

IF SHEET IS LESS THAN
594 X 841
IT IS A REDUCED PRINT
SCALE REDUCED ACCORDINGLY

THE CONTRACTOR SHALL BE RESPONSIBLE
FOR COORDINATING THE WORK AMONG
THE VARIOUS TRADES AS NECESSARY TO
AVOID CONFLICTS AND TO INSURE THE
INSTALLATION OF ALL WORK WITHIN THE
AVAILABLE SPACE.

CATHODIC PROTECTION LEGEND	
	RECTIFIER R-5 CATHODIC PROTECTION SYSTEM SEE DETAIL
	NEW CATHODIC PROTECTION TEST STATION WELDED TO STRUCTURE USING THE EXOTHERMIC WELD PROCESS SEE DETAIL
	EXOTHERMIC WELD TO PIPE SEE DETAIL

AS-BUILT DRAWINGS

Revised by
F. Carter
3-15-00



PSG Corrosion Engineering 8840 Complex Dr. Ste. 100 San Diego, CA 92123	DEPARTMENT OF THE NAVY NAVAL FACILITIES ENGINEERING COMMAND SOUTHWEST DIVISION SAN DIEGO, CALIFORNIA
DES CKM DR EC CHK PUR SUBV OKM CH ENG RBJ DATE 4-22-99	DFSP ROOSEVELT ROADS PROJECT FY 97, RRD 97-3 REPAIR CATHODIC PROTECTION SYSTEMS DFSP ROOSEVELT ROADS
SW DIV NFEC-RVD DIR PDE INBM	RECTIFIER R-5 SITE PLAN
APPROVED	SIZE D
SATISFACTORY TO DATE	CODE IDENT. NO. 80091
TITLE CP-6	NAVAC DRAWING NO. 8129758
FOR COMMANDER NAVFAC DATE	CONST. CONTR. NO. N67811-98-C-5742
	SPEC. 11-98-5742 SHEET 7 OF 15